

INSTALLATION INSPECTION REPORT

Application No. 571

Date Oct 1, 1984

Name Hester Fuhle

Lot 11 Blk. _____ Sec. _____ Subdivision Melody Hill Estates

Area _____ Tract _____ Lot _____

Contractor Dorley

Septic Tank: Size 1,000 gallons Material Concrete

Plumbing PVC Lid(s) con Structural features _____

Absorption Field: Size 800 square feet Length 320

Width 2.5 Depth 2 Slope L


Gravel Depth - under lines 6'' in.; over lines 2'' in.

Barrier _____ Type of backfill material sand

RESULTS: This installation is satisfactory unsatisfactory _____

Deight McHenry
Inspector

AS-BUILT SKETCH AND COMMENTS:

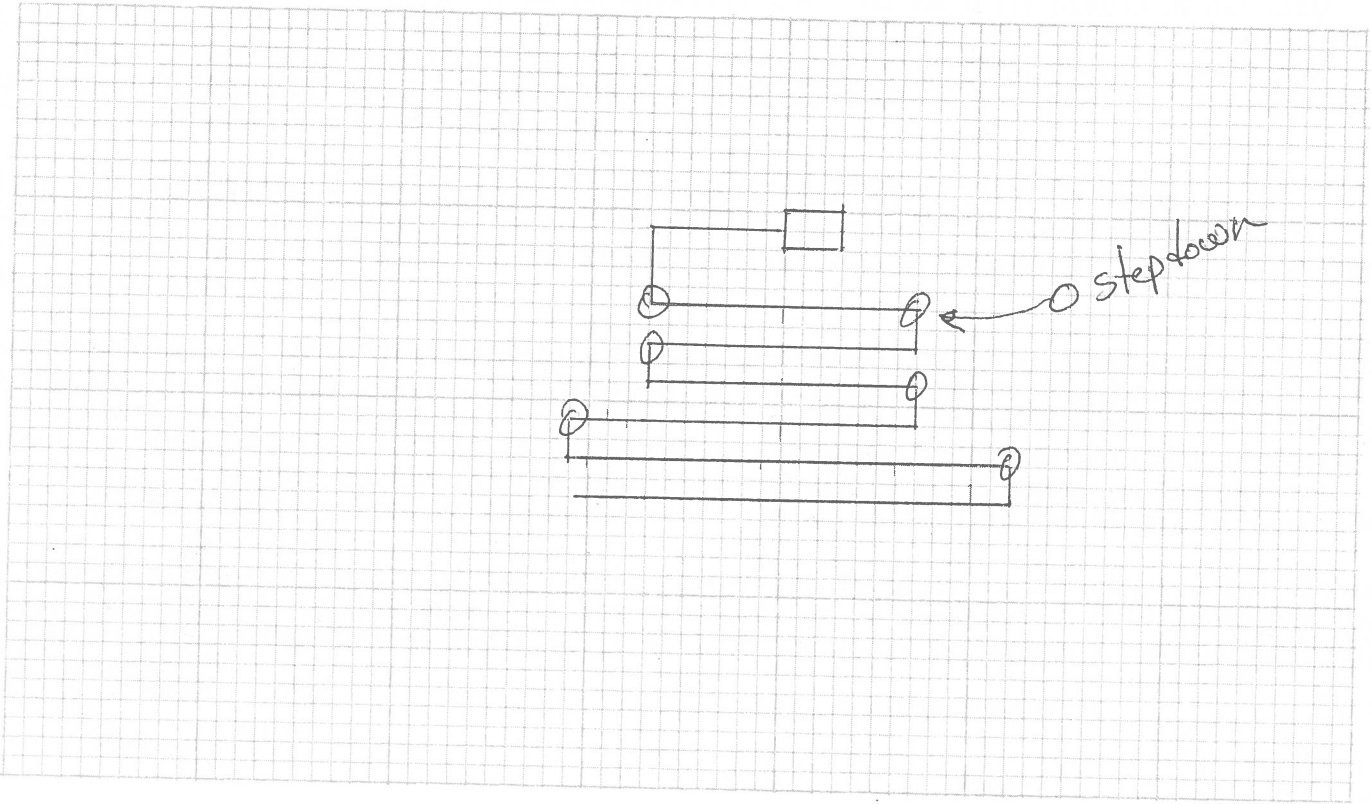

APPLICATION FOR PERMIT FOR PRIVATE FACILITY
ON LAKE LIMESTONE

REVISION:
PRIVATE FACILITY
PERMIT #5383

To: Brazos River Authority
Route 3, Box 89A
Thornton, Texas 76687

Telephone: 214-529-2141

Name of Applicant Lester Fahle Office Telephone: Home (817) 729-2672

Mailing Address Rt. 2, Box 223-C Groesbeck Texas 76642
Street City State Zip Code

Applicant hereby requests permission to construct, maintain, and use the following described private facility in or on Lake Limestone; and Applicant represents that all necessary land-rights on the adjoining lakeshore land at the site of the requested facility are held by Applicant.

Location of structure or facility (give information clearly identifying the location; such as; tract number, lot number, subdivision, etc.): Lot 11 - Melody Hill Estates

Type of structure or facility for which permit is requested (dock, pier, ramp, boathouse, swimming area, etc.): pier

Dimensions of main structure or facility: 20 x 10' 4 25 ft. by 20 ft.; Walkway: 5 ft. by 40 ft.
Attach a sketch of the proposed facility showing all dimensions, including minimum distances from the facility to lot boundaries as such boundaries are extended into the lake.

Date of start of construction: June 1990

The annual permit fee for the privilege of constructing and maintaining the requested facility in or on Lake Limestone is 5¢ per square foot of lake area required for the facility or 5¢ per square yard for private swimming areas, with the minimum fee being \$25.00 per calendar year. Payment of the prorated fee for the remaining calendar months of the first year, including the month when construction will start, must accompany this application. Subsequent fees are due on the first day of January of each succeeding year.

Applicant agrees to observe all applicable Lake Limestone rules and regulations and other requirements of Brazos River Authority with regard to the construction, maintenance, and use of the requested facility, including specifically the conditions listed on the back of this form. If Applicant fails to observe the applicable regulations and requirements of Brazos River Authority or fails to pay the annual permit fee when due, Brazos River Authority may cancel this permit on 30 days notice.

APPLICANT UNDERSTANDS THAT THE LAKE LEVEL WILL NOT BE CONSTANT AND MAY DROP AS MUCH AS 33 FEET OR MORE DURING DROUGHT PERIODS; ALSO, THE LAKE LEVEL MAY RISE DURING FLOODS, AND IN SOME AREAS, FLOODS MAY COVER LAND AT ELEVATIONS AS MUCH AS 5 TO 10 FEET OR MORE ABOVE THE NORMAL MAXIMUM LAKE LEVEL.

Date: 6-18-90

Signature of Applicant: Lester Fahle

DO NOT WRITE BELOW THIS LINE

Approval recommended by: Dezelle Grey Date: 6/18/90

Permit approved to not exceed 700 square feet of lake area.
800

BRAZOS RIVER AUTHORITY
By: Richard Placer
Annual Fee: \$45.00 40.00

Date: 6-20-90
Permit No.: 5383

*Revise Fee to 40.00 - Also, 40.00
to be used for 1991 which has been paid - should*